DHDS

Georgia Department of Public Health
ON-SITE SEWAGE MANAGEMENT SYSTEM INSPECTION REPORT

CONSTRUCTION PERMIT NUMBER: 207

COUNTY	COUNTY CODE	HEALTH DISTRICT	MONTH	DAY	YEAR
Oglethorpe	109	10	05	19	21

SUBDIVISION: | LOT | PROPERTY OWNER: SRE Homes

PROPERTY LOCATION / ADDRESS: 360 Wolfskin

SEWAGE CONTRACTOR: Frank Newkirk

CONTRACTOR LICENSE:

ALL ITEMS: (BLANK) = Not Applicable (0) = Unknown ***ITEMS** (1) = Yes (2) = No

Section A - General

1. WATER SUPPLY: (1) Public (2) Private (3) Community — 2
2. ** TYPE OF STRUCTURE: (see below) — 1
3. STRUCTURE AGE: (1) New (2) <1 year (3) >1 year — 1
4. SEWAGE SYSTEM: (1) New (2) Repair (3) Addition — 1
5. AGE OF SYSTEM (repairs): (1) <1 (2) 1-5 (3) 6-10 (4) 11-20 (5) 21-30 (6) 31-40 (7) >40 — ✓
6. * IN SUBDIVISION?: — ✓
7. WATER USAGE BY: (1) Bedroom Numbers (2) Gallons per Day — 1
8. NO. OF BEDROOMS/ GALLONS PER DAY: — 4
9. LOT SIZE:
10. PERCOLATION RATE/ LOADING RATE: — 55
11. SOIL CLASSIFIER: Phillip Archer
12. SOIL SERIES: Cecil

Section B – Primary / Pretreatment

1. DISPOSAL METHOD: (1) Septic Tank (2) Privy (3) Aerobic Unit (4) Other: — 1
2. SEPTIC TANK:
   a. Capacity (gals): — 1000
   b. Material: (1) Concrete (2) Polyethylene (3) Fiberglass (4) Poured (5) Other:
   c. Distance from (feet):
      (1) Well: 200
      (2) Building: 10
      (3) Lake/Stream:
      (4) Nearest property line: 65
   d. Manufacturer: B&B
3. FILTER MANUFACTURER/ MODEL: Infiltrator
4. AEROBIC UNIT:
   a. Treatment capacity:
   b. Manufacturer:
5. DOSING TANK CAP.(gals):
6. GREASE TRAP CAP.(gals):

Section C – Secondary Treatment

1. ABSORPTION FIELD DESIGN: (1) Level (2) Serial (3) Drip (4) Bed (5) Distribution box (6) Mound (7) Other: — 2
2. ABSORPTION FIELD:
   a. Total square feet: 855
   b. Total linear feet: 285
   c. Number of trenches:
   d. Length trenches (feet):
   e. Distance between trenches (feet): 8
   f. Depth of trenches (range in inches): 24–36
   g. * Aggregate proper size:
   h. * Aggregate proper depth:
   i. Distance from (feet):
      (1) Well: 115
      (2) Building: 25
      (3) Lake/Stream:
      (4) Nearest property line: 95
   j. Nearest property line: (1) Right (2) Left (3) Front (4) Rear — 3
   k. Product used: Arc 36

** TYPE OF FACILITY
(1) Single-Family Residence
(2) Multi-Family Residence
(3) Commercial ≤2000
(4) Commercial ≥2000
(5) Restaurant
(6) Mobile Home Park
(7) Other (specify) _____

REMARKS:

Drawing not to scale.

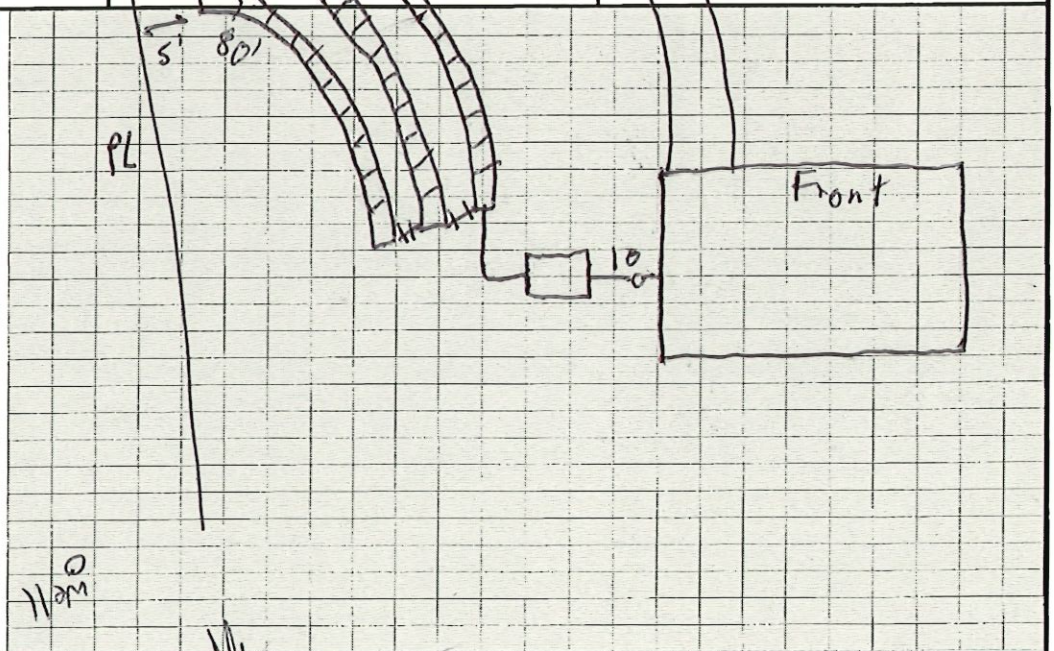

Issuance of a construction permit for an on-site sewage management system, and subsequent approval of same by representatives of the County Board of Health shall not be construed as a guarantee that such systems will function satisfactorily for a given period of time; furthermore, said representatives do not, by any action taken in affecting compliance with these rules, assume any liability for damages which are caused, or which may be caused, by the malfunction of such system.

ENVIRONMENTALIST: Wally Mint | TITLE: EP | *SYSTEM APPROVED: (see Sect. A 7 & 8)

Form 3884 (Rev. 1 – 2014)